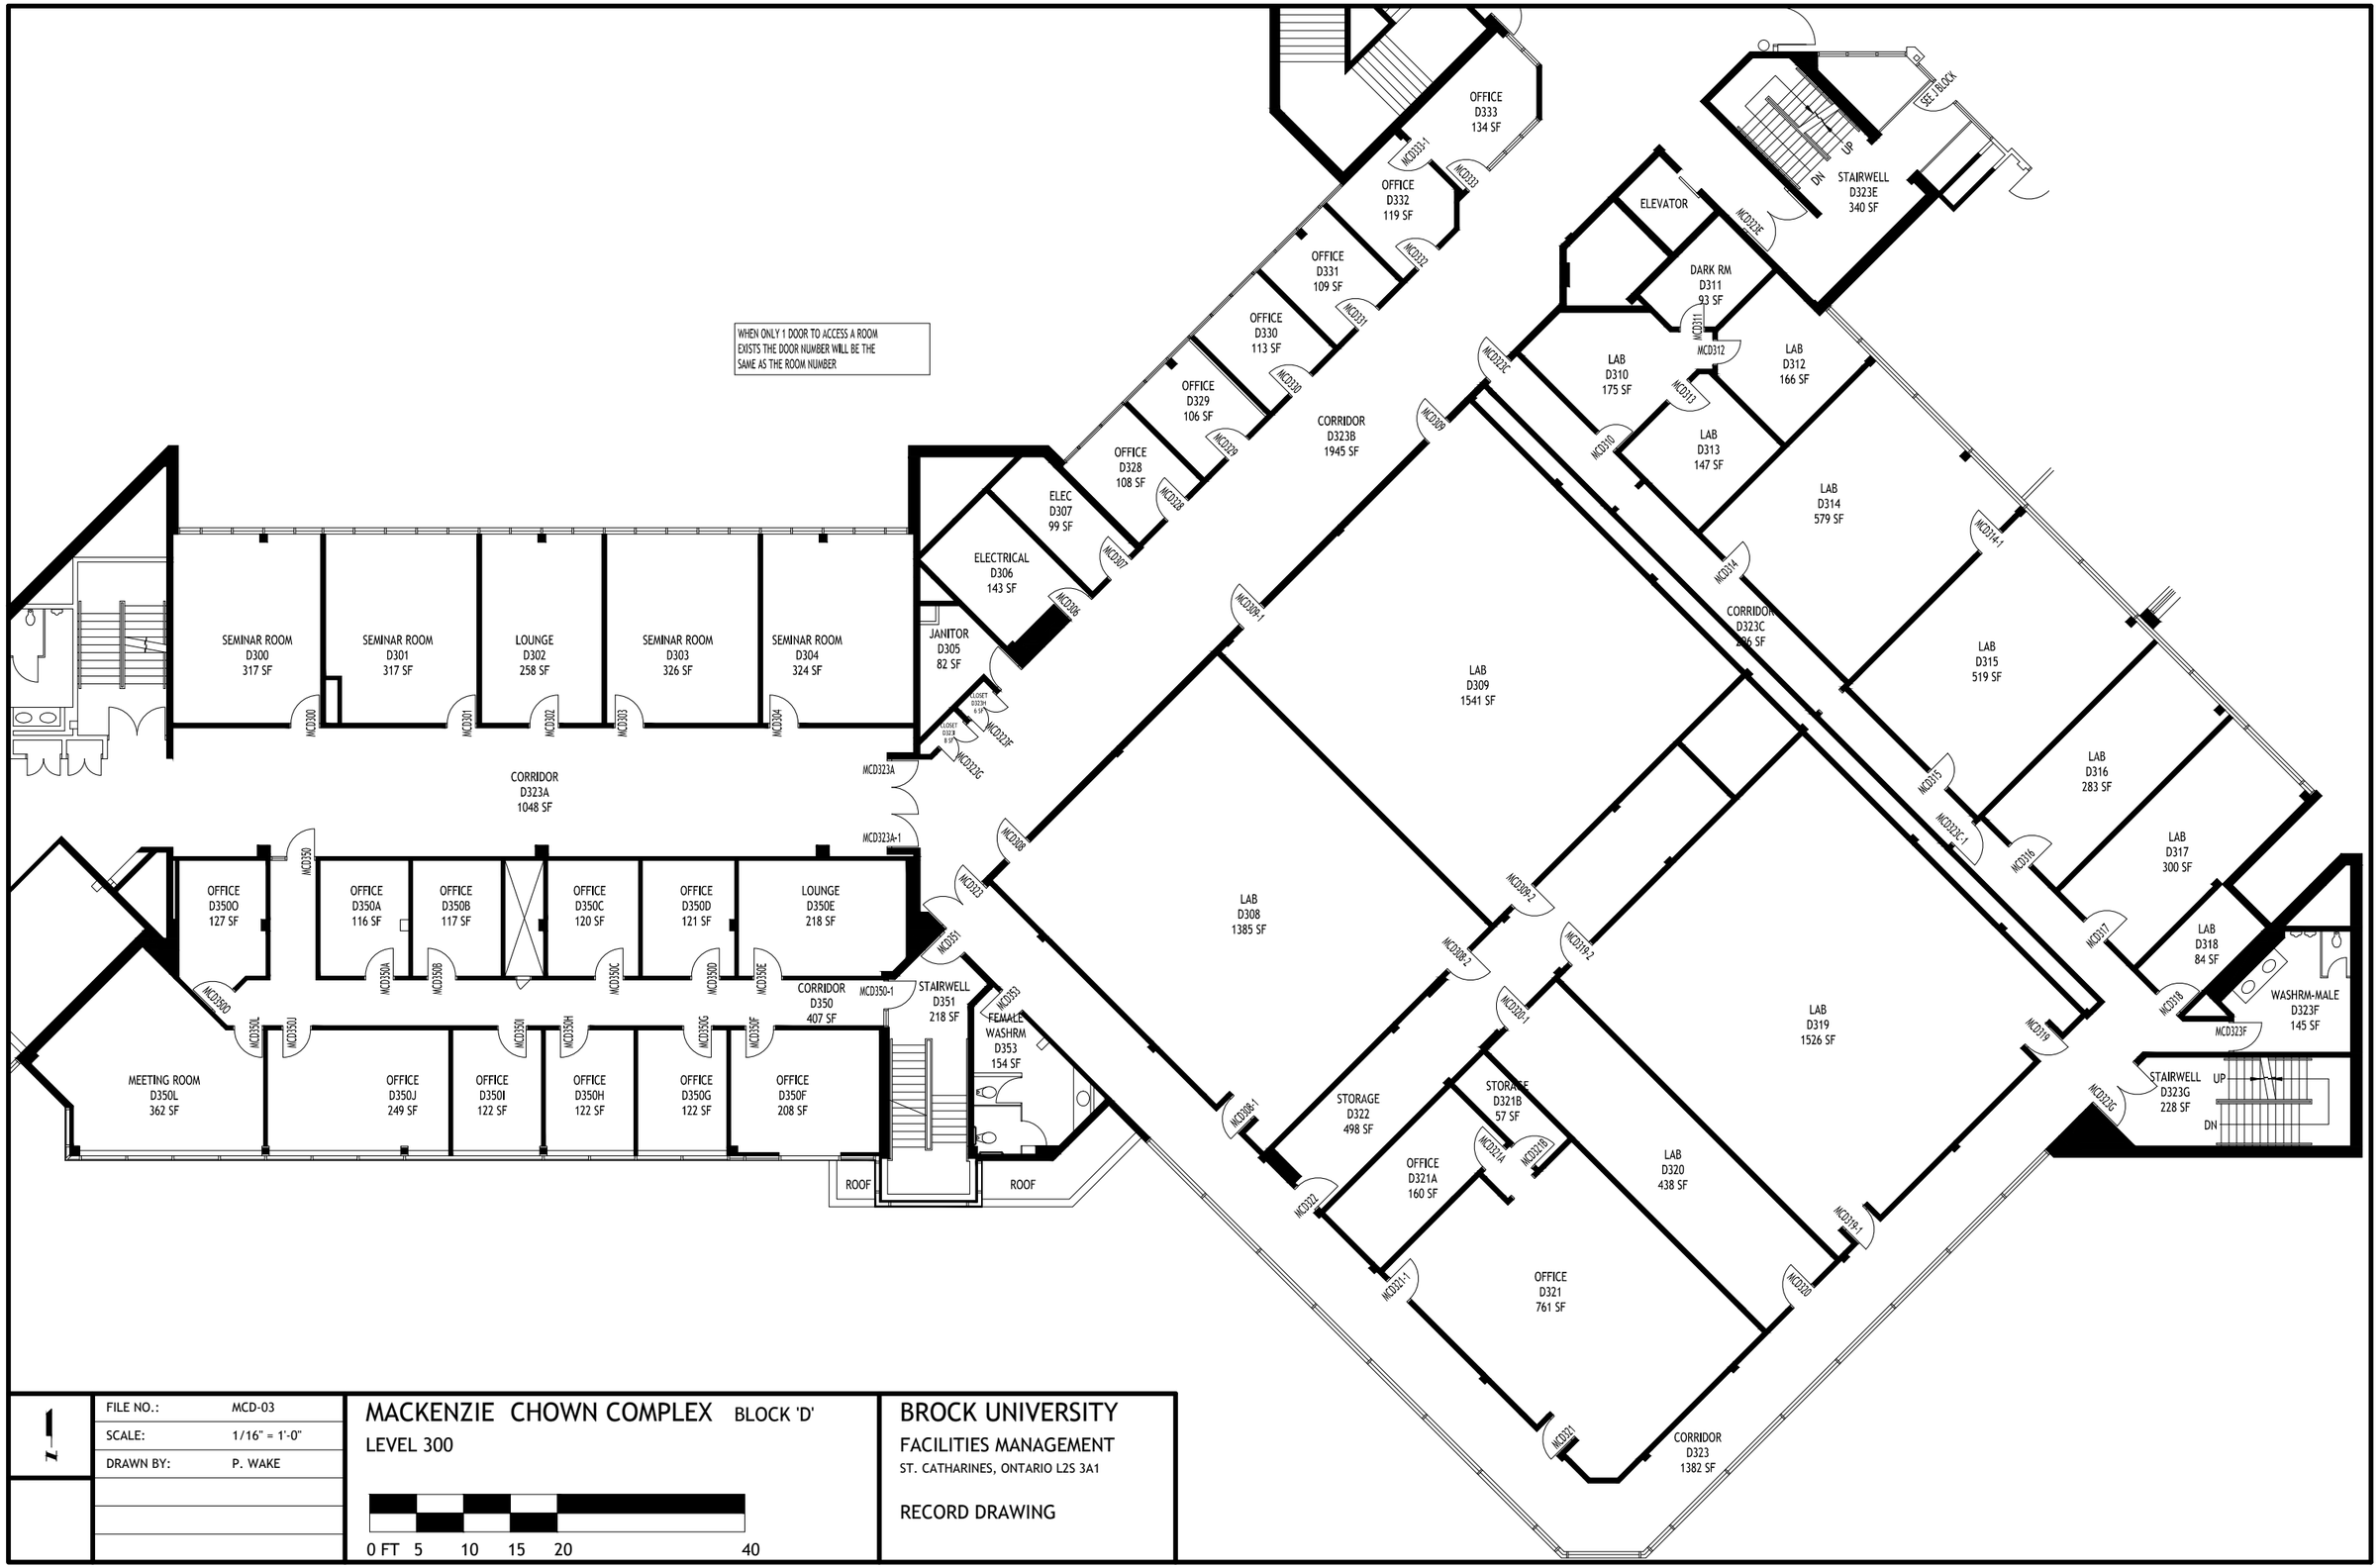

FILE NO.:	MCD-03
SCALE:	1/16" = 1'-0"
DRAWN BY:	P. WAKE

MACKENZIE CHOWN COMPLEX BLOCK 'D'

LEVEL 300

0 FT 5 10 15 20 40

BROCK UNIVERSITY

FACILITIES MANAGEMENT

ST. CATHARINES, ONTARIO L2S 3A1

RECORD DRAWING